


1" = 200'
(24"X36")

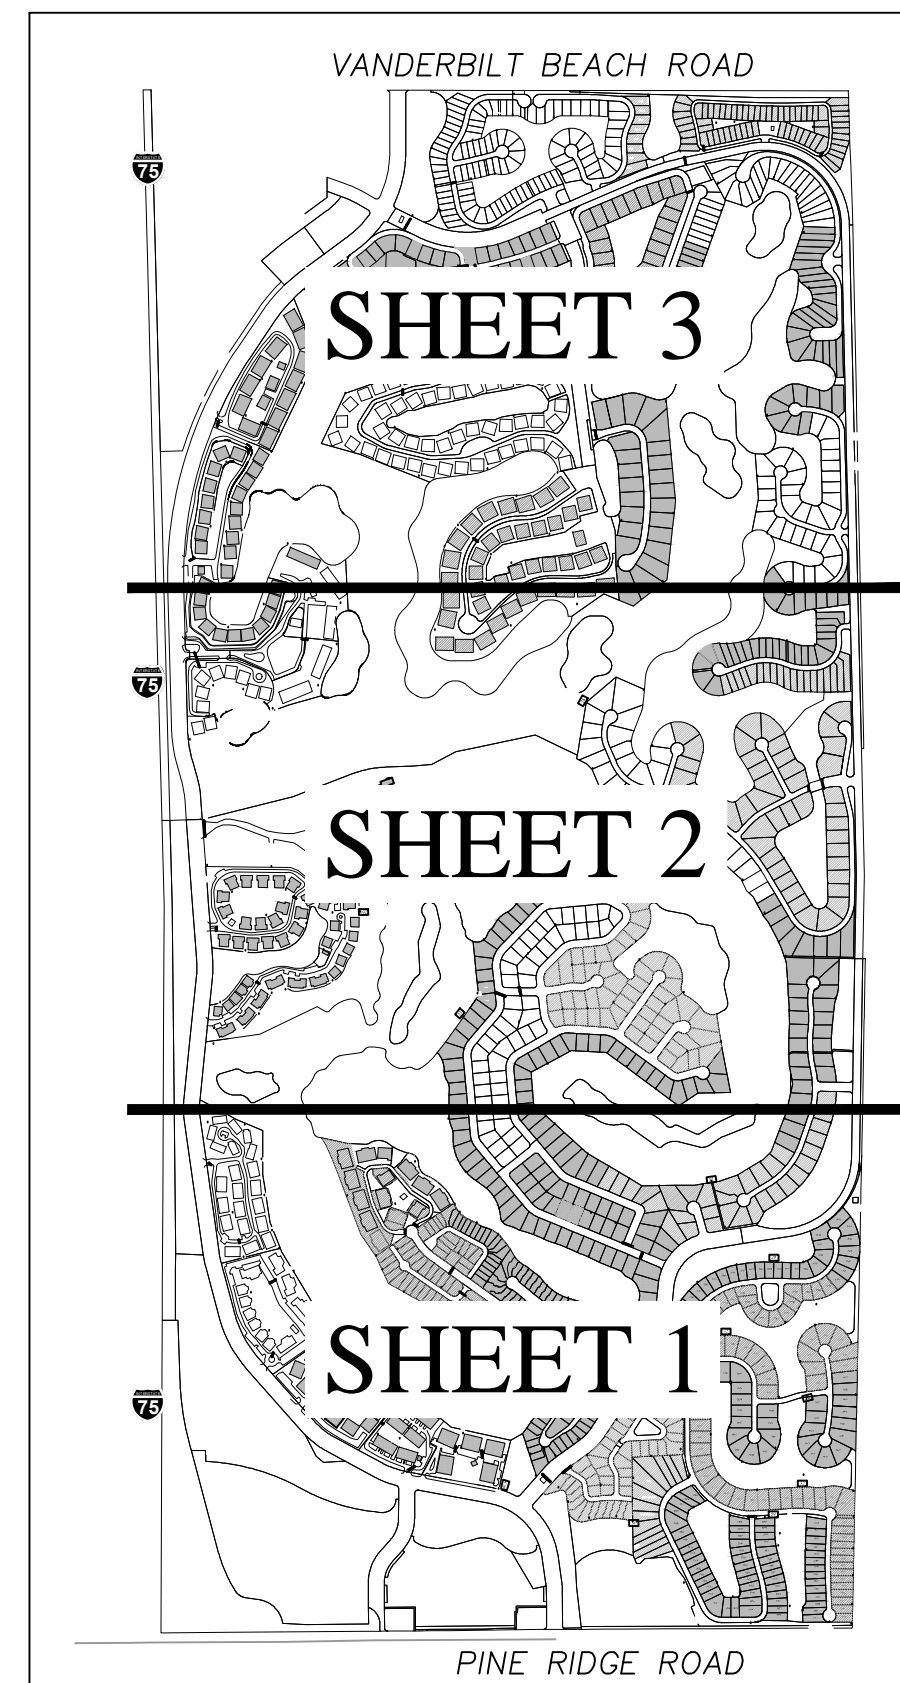

PROJECT NAME:

VINEYARDS GOLF & COUNTRY CLUB

- 4 - RESIDENTIAL \ BUILDING FIBER COUNT
- 6 - RESIDENTIAL \ BUILDING FIBER COUNT
- 8 - RESIDENTIAL \ BUILDING FIBER COUNT
- 12 - RESIDENTIAL \ BUILDING FIBER COUNT
- PH - POOL HOUSE
- UMG - UNMANNED GUARDHOUSE

LEGEND

- 5999 - HOUSE ADDRESS
- 59 - SPLITTER CABINET W\UNIT COUNT
- V - VAULT BOX
- DISTRIBUTION LINE W\ LENGTH

SC-3 - SPLITTER CABINET W\ID NUMBER

PLAN VIEW

NUVU
28901 TRAILS EDGE BLVD BLDG. 203
BONITA SPRING, FLORIDA 34134
PHONE: 239-284-9038 - FAX: 239-992-6812